




FRONT ELEVATION
Scale 1:2.5

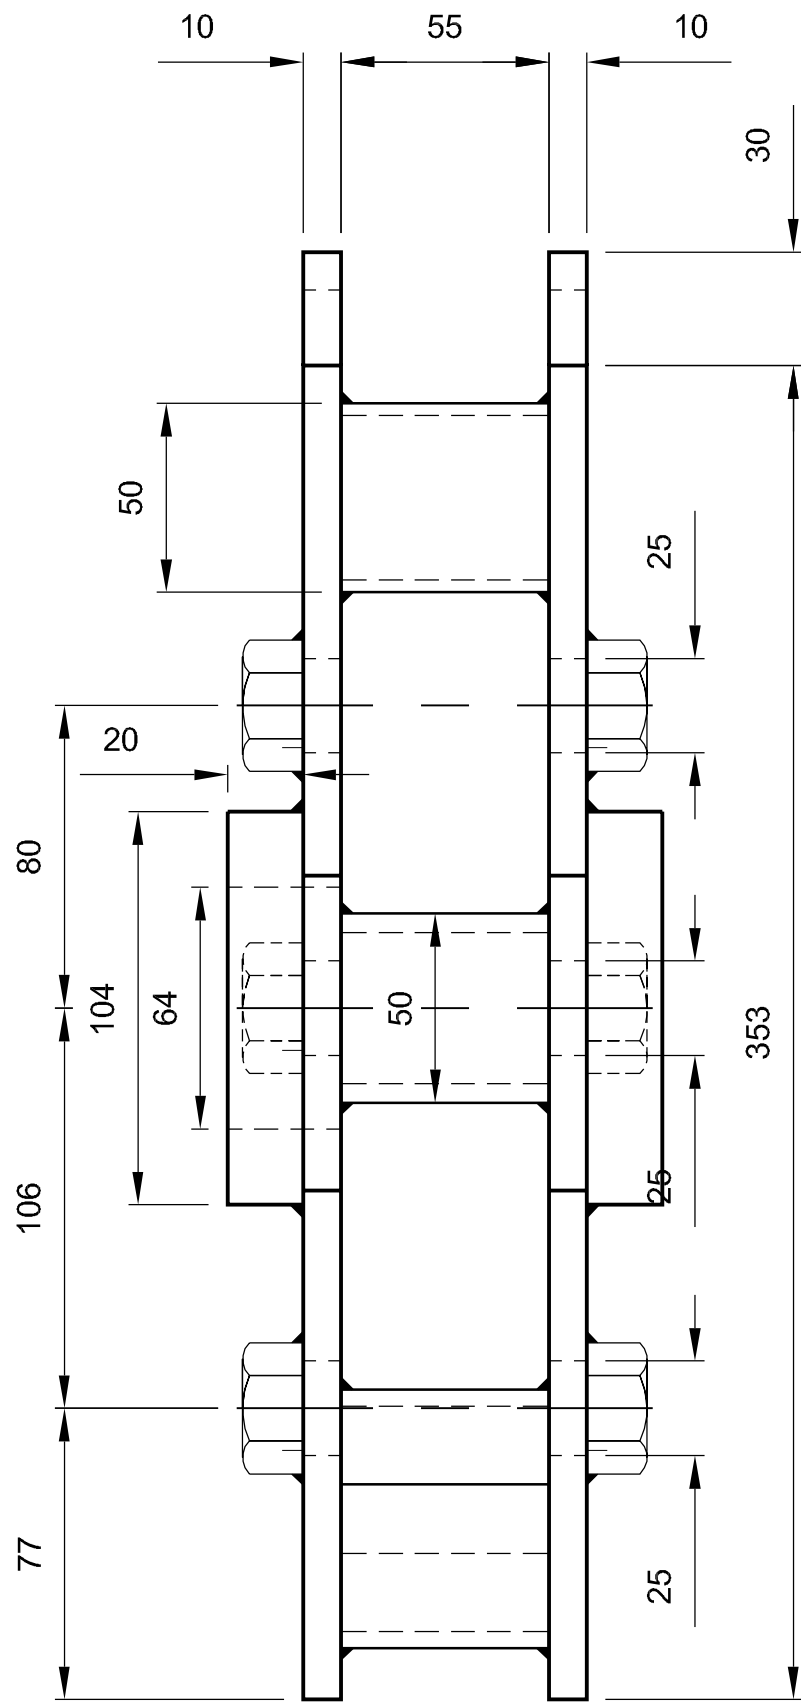


SIDE ELEVATION
Scale 1:2.5

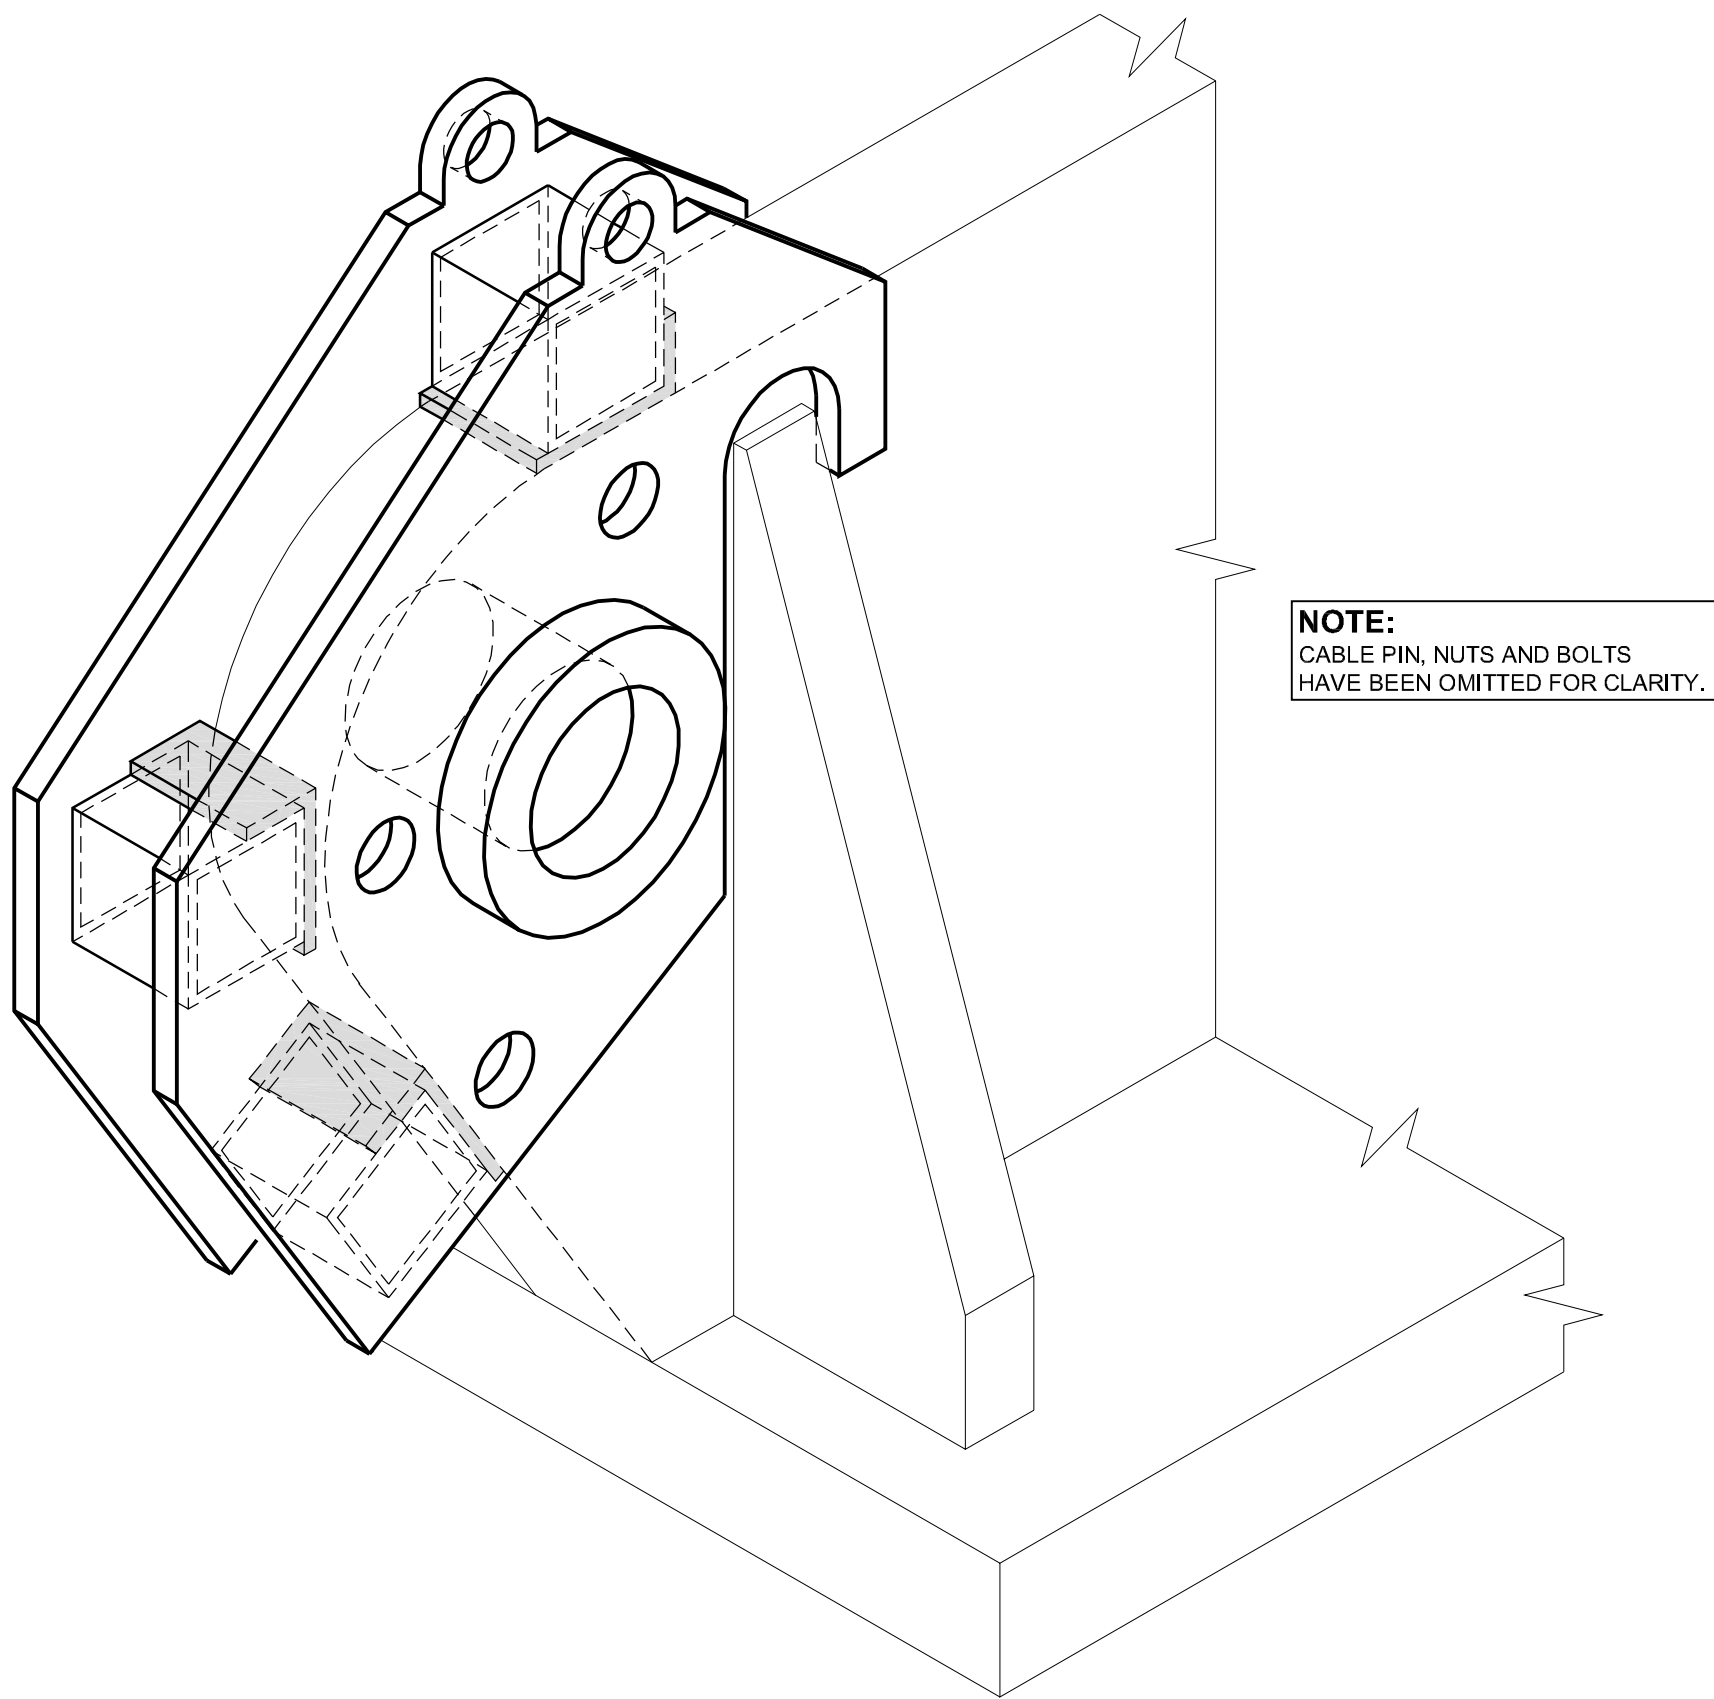


ISOMETRIC VIEW

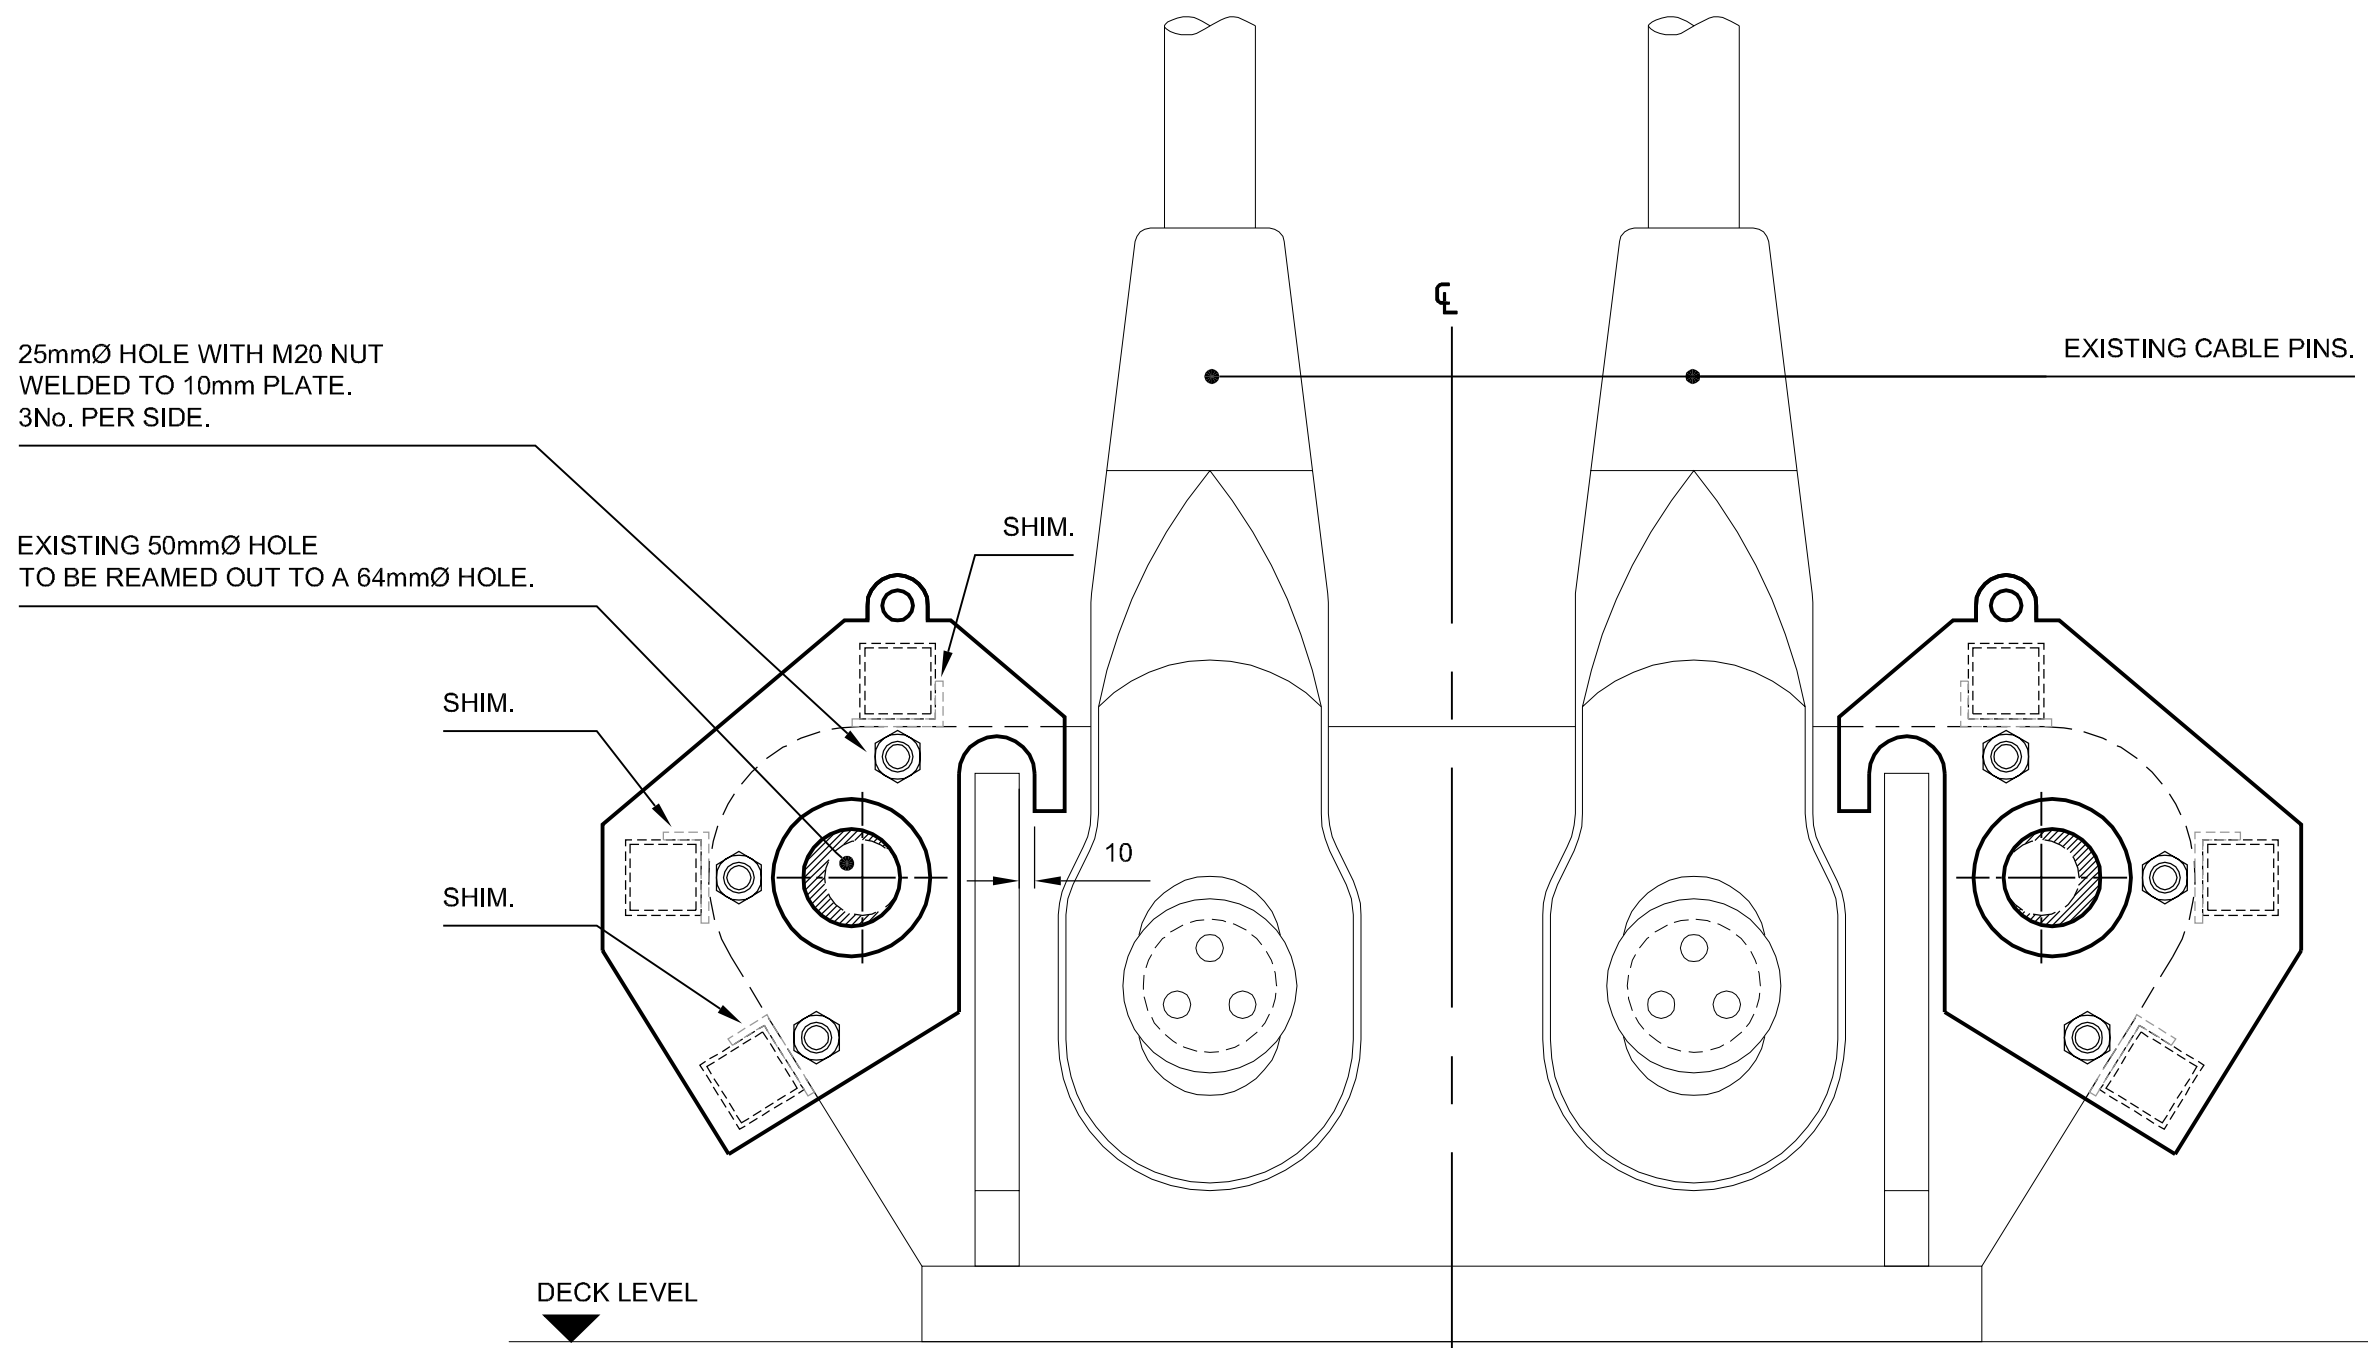

FRONT ELEVATION ON SIDE SPAN ROPE SOCKET
Scale 1:5

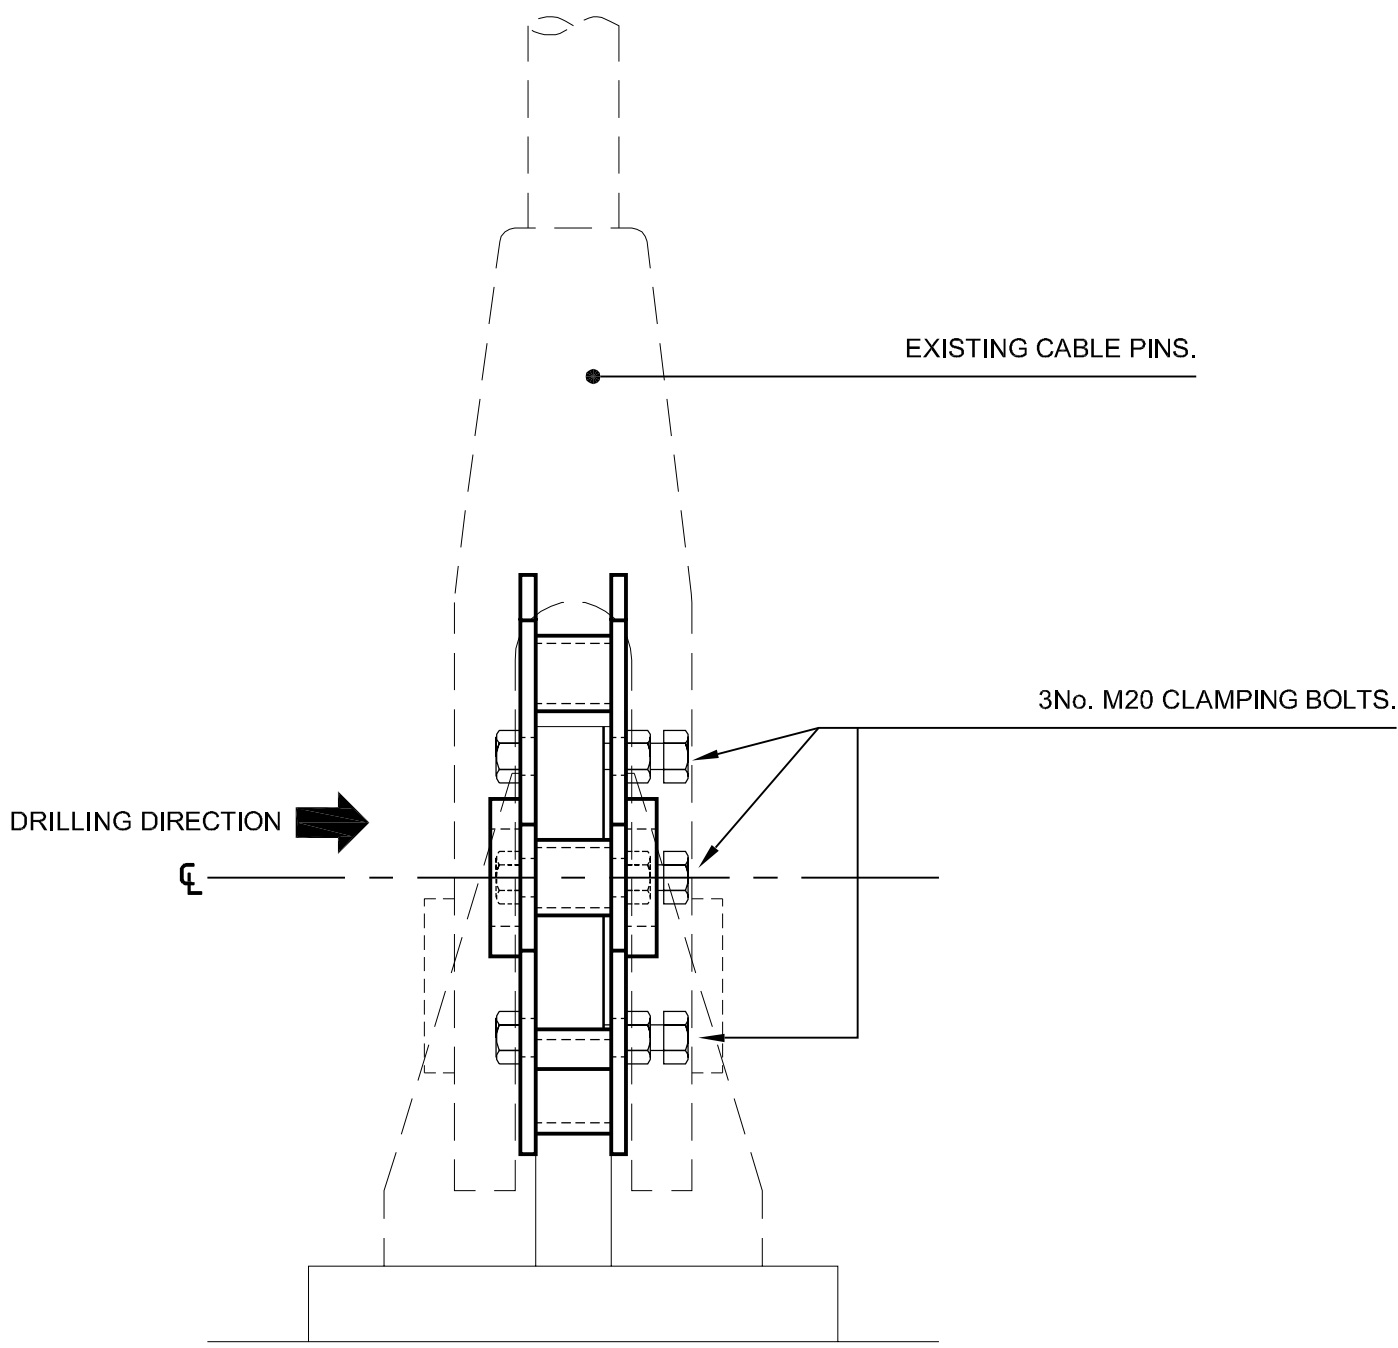

SIDE ELEVATION ON SIDE SPAN ROPE SOCKET
Scale 1:5

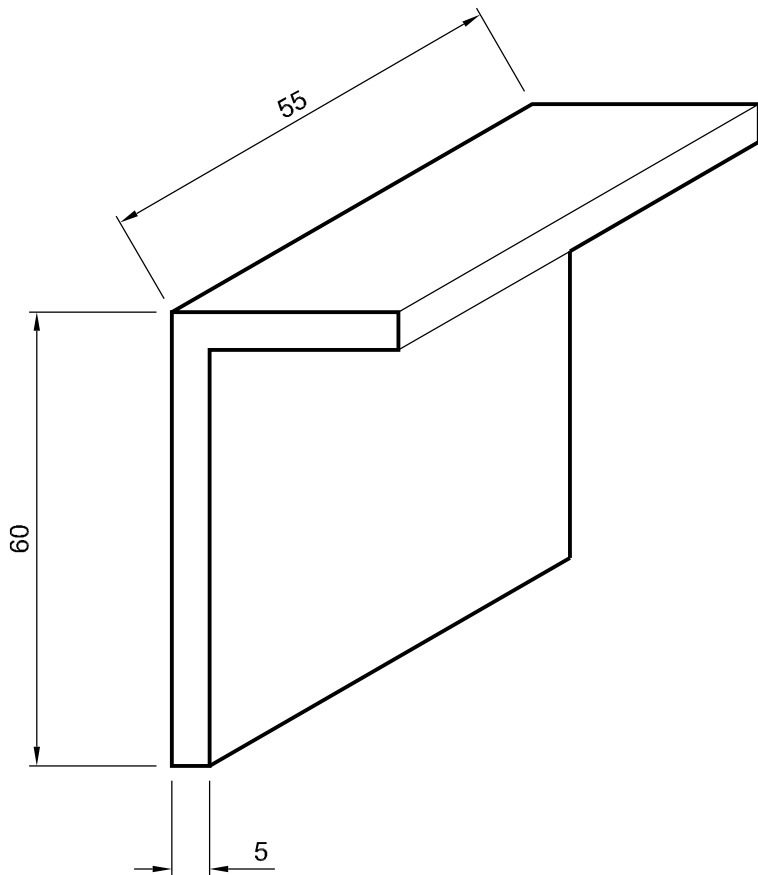

SHIM DETAIL
Scale 1:1

GENERAL NOTES

1. ALL DIMENSIONS ARE IN MILLIMETRES UNLESS OTHERWISE STATED.
2. DIMENSIONS MUST NOT BE SCALED FROM THIS DRAWING.

Rev	Date	Detail	Made	Chk'd	App'd
B	11/11/09	ISSUED AS "AS - BUILT"	MPS	MJB	CPEC
A	28/03/2009	INITIAL ISSUE.	MPS	MJB	CPEC

Status :

AS BUILT

Client :

Forth Estuary Transport Authority

Project :
**FORTH ROAD BRIDGE
MAIN CABLE
DEHUMIDIFICATION SYSTEM**

Title :
**ADDITIONAL WORKS
NORTH EAST SIDE SPAN
PP's 18NE, 22, 26, 32 & 42
STAGE 2 HOLE REAMING JIG**

Eng : MJB	CAD : MPS
Chk'd : MJB	App'd : CPEC
Date : MARCH 2009	Scale : AS SHOWN

AECOM

5th Floor
2 City Walk,
LEEDS, LS11 9AR

Tel: +44 (0) 113 391 6800
Fax: +44 (0) 113 391 6899
www.aecom.com

No. 47484/W/924

Rev: B