"This document has been prepared by AECOM Ltd ("AL") for the sole use of our Client (the "Client") and in accordance with generally accepted consultancy principles, the budget for fees and the terms of reference agreed between AL and the Client. Any information provided by third parties and referred to herein has not been checked or verified by AL, unless otherwise expressly stated in the document. No third party may rely upon this document without the prior and express written agreement of AL"

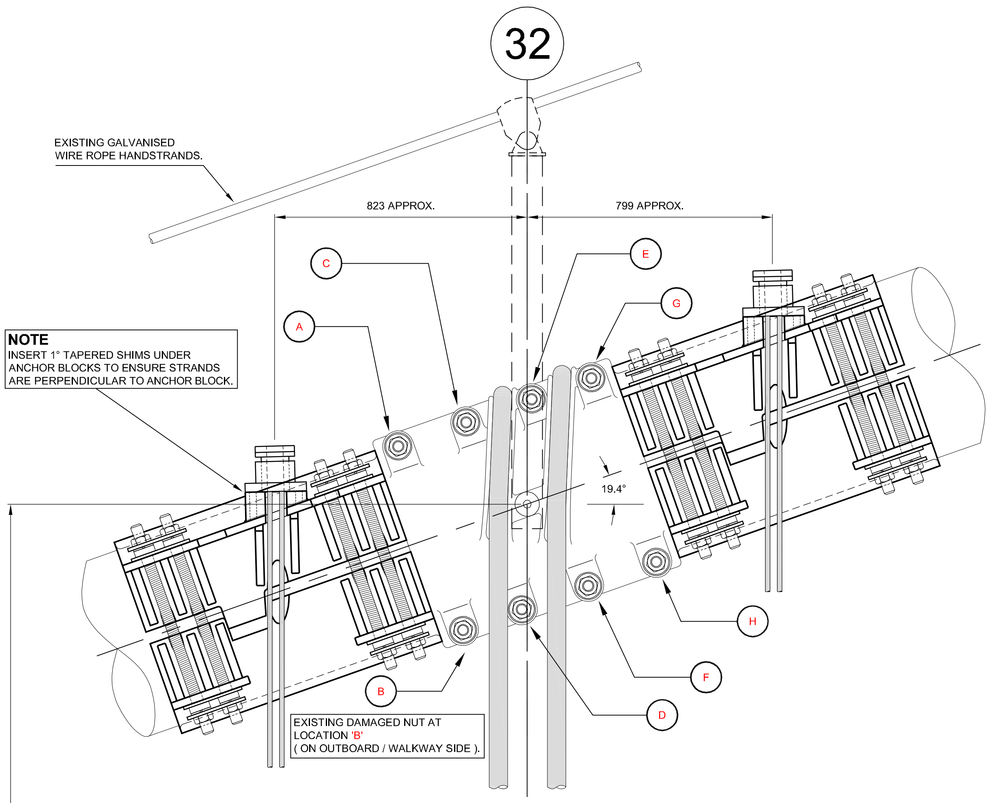

STAGE 2 OUTLINE PROCEDURE

TASKS 1, 3, 4, 8, AND 9 OF THE FOLLOWING PROCEDURE SHALL BE CARRIED OUT BY C.S.L. IN THE PRESENCE OF THE PROJECT MANAGERS INSPECTOR. TASKS 2, 5, 6 AND 7 SHALL BE CARRIED OUT BY F.E.T.A.

1. C.S.L. SHALL INSTALL AN ADDITIONAL UPPER TEMPORARY CABLE BAND AS DESCRIBED IN STAGE 1, WITH RODS SPANNER TIGHT.
2. THE TEMPORARY CABLE BAND THREADED RODS SHALL BE CAREFULLY TENSIONED BY F.E.T.A. TO AN APPROVED SEQUENCE IN ORDER TO MAINTAIN EVEN AND EQUAL GAPS BETWEEN TWO HALVES.
3. C.S.L. SHALL INSTALL TEMPORARY STRANDS, ANCHOR BLOCKS, ADJUSTABLE ANGERS AND PROPRIETARY 60t JACKS TO AN APPROVED PROCEDURE.
4. C.S.L. SHALL SIMULTANEOUSLY TENSION TEMPORARY STRANDS IN Max. 5t INCREMENTS UNTIL ALL LOAD IS REMOVED FROM THE PERMANENT HANGERS. EXPECTED TENSION IN EACH OF THE 4 HANGER LEGS IS 40t (DEAD LOAD ONLY) TO 45t (WITH TRAFFIC).
5. F.E.T.A. SHALL DE-TENSION ALL CABLE BAND BOLTS IN ¼ TURN INCREMENTS TO AN APPROVED SEQUENCE AND MANOEUVRE THE TWO HALVES OF THE CABLE BAND TO ALLOW THE DAMAGED CABLE BAND BOLT TO BE REMOVED.
6. CAREFULLY REPLACE THE DAMAGED CABLE BAND BOLT WITH A NEW BOLT.
7. F.E.T.A. SHALL TENSION ALL BOLTS IN ACCORDANCE WITH THEIR EXISTING TENSIONING PROCEDURES.
8. WHEN THE PERMANENT CABLE BAND BOLTS HAVE BEEN FULLY TENSIONED, C.S.L SHALL SIMULTANEOUSLY DE-TENSION TEMPORARY STRANDS IN Max. 5t INCREMENTS THEN REMOVE TEMPORARY HANGERS IN A SAFE MANNER.
9. THE TEMPORARY CABLE BAND THREADED RODS SHALL BE CAREFULLY DETENSIONED BY F.E.T.A
10. C.S.L. SHALL REMOVE THE TEMPORARY CABLE BAND REINSTATE CABLE GUARD WRAPPING AND SEALING MATERIALS.

GENERAL NOTES

1. ALL DIMENSIONS ARE IN MILLIMETRES UNLESS OTHERWISE STATED.
2. DIMENSIONS MUST NOT BE SCALED FROM THIS DRAWING.
3. SEE DRAWING No. 47484/W/902 FOR TEMPORARY CABLE BAND STEELWORK DETAILS.

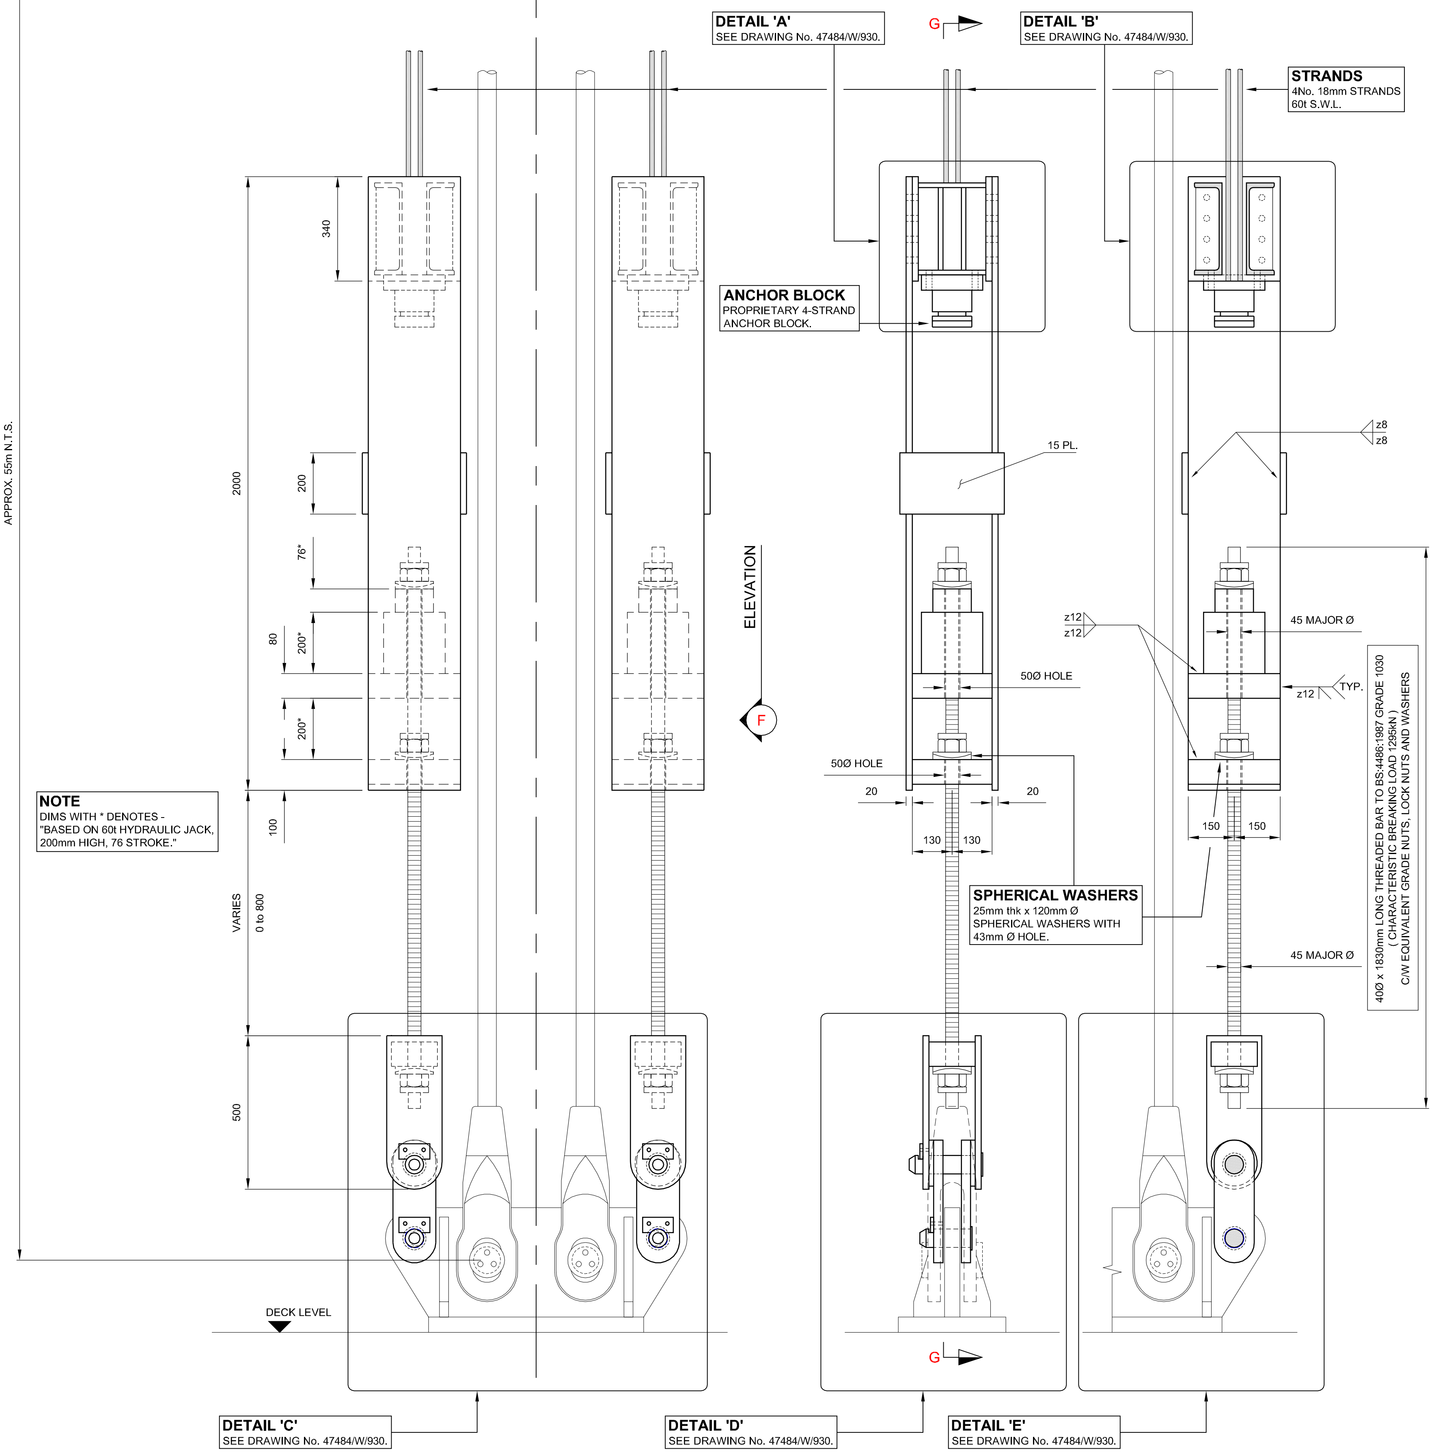

STAGE 2
NORTH EAST ELEVATION (LOOKING DOWNSTREAM)
ON CABLE BAND 18

ELEVATION 'F'

SECTION 'G - G'

Rev	Date	Detail	Made	Chk'd	App'd
C	11/11/09	ISSUED AS "AS - BUILT"	MPS	MJB	CPEC
B	12/05/2009	WASHER PLATES ADDED TO TEMPORARY CABLE BANDS.	MPS	MJB	CPEC
A	24/03/2009	INITIAL ISSUE	MPS	MJB	CPEC

Status: AS BUILT

Client: Forth Estuary Transport Authority

Project: FORTH ROAD BRIDGE MAIN CABLE DEHUMIDIFICATION SYSTEM

Title: ADDITIONAL WORKS
CABLE BAND BOLT REPLACEMENT
NE SIDE SPAN - PP 32NE STAGE 2

Eng:	MJB	CAD:	MPS
Chk'd:	MJB	App'd:	CPEC
Date:	MARCH 2009	Scale:	AS SHOWN

AECOM
5th Floor,
2 City Walk,
LEEDS, LS11 9AR
Tel: +44 (0) 113 391 6800
Fax: +44 (0) 113 391 6899
www.aecom.com

No. 47484/W/928 Rev: C

A1

cm

PLOTTED BY: SHOESMITH, MARK P DATE: Tuesday, November 17, 2009
F:\PROJECTS\47484TLEE Forth Road Bridge Cable\08 Drawings\Forth Bridge Working Drawings\47484-W-928.dwg [AutoCAD Location]